

ELEVATION CERTIFICATE

Important: Read the instructions on pages 1-9.

OMB No. 1660-0008
 Expiration Date: July 31, 2015

SECTION A - PROPERTY INFORMATION

FOR INSURANCE COMPANY USE
 Policy Number
 Company NAIC Number

A1. Building Owner's Name **STEVE PETTEE**
 A2. Building Street Address (including Apt., Unit, Suite, and/or Bldg. No.) or P.O. Route and Box No.
200 ROBERTS ROAD
 City **NOKOMIS** State **FL** ZIP Code **34275**

A3. Property Description (Lot and Block Numbers, Tax Parcel Number, Legal Description, etc.)
LOT 4, BLOCK A, LAUREL VILLA

A4. Building Use (e.g., Residential, Non-Residential, Addition, Accessory, etc.) **RESIDENTIAL**
 A5. Latitude/Longitude: Lat. **27°08.534'** Long. **82°27.843'** Horizontal Datum: NAD 1927 NAD 1983
 A6. Attach at least 2 photographs of the building if the Certificate is being used to obtain flood insurance.
 A7. Building Diagram Number **1**

A8. For a building with a crawlspace or enclosure(s): a) Square footage of crawlspace or enclosure(s) 110 sq ft b) Number of permanent flood openings in the crawlspace or enclosure(s) within 1.0 foot above adjacent grade 0 c) Total net area of flood openings in A8.b 0 sq in d) Engineered flood openings? <input type="checkbox"/> Yes <input checked="" type="checkbox"/> No	A9. For a building with an attached garage: a) Square footage of attached garage 448 sq ft b) Number of permanent flood openings in the attached garage within 1.0 foot above adjacent grade 0 c) Total net area of flood openings in A9.b 0 sq in d) Engineered flood openings? <input type="checkbox"/> Yes <input checked="" type="checkbox"/> No
---	---

SECTION B - FLOOD INSURANCE RATE MAP (FIRM) INFORMATION

B1. NFIP Community Name & Community Number SARASOTA COUNTY - 125144		B2. County Name SARASOTA		B3. State FLORIDA	
B4. Map/Panel Number 125144 - 0239	B5. Suffix D	B6. FIRM Index Date 9/3/92	B7. FIRM Panel Effective/Revised Date 5/1/84	B8. Flood Zone(s) A12	B9. Base Flood Elevation(s) (Zone AO, use base flood depth) 11'

B10. Indicate the source of the Base Flood Elevation (BFE) data or base flood depth entered in Item B9.
 FIS Profile FIRM Community Determined Other/Source: _____

B11. Indicate elevation datum used for BFE in Item B9: NGVD 1929 NAVD 1988 Other/Source: _____

B12. Is the building located in a Coastal Barrier Resources System (CBRS) area or Otherwise Protected Area (OPA)? Yes No
 Designation Date: **N/A** CBRS OPA

SECTION C - BUILDING ELEVATION INFORMATION (SURVEY REQUIRED)

C1. Building elevations are based on: Construction Drawings* Building Under Construction* Finished Construction
 *A new Elevation Certificate will be required when construction of the building is complete.

C2. Elevations - Zones A1-A30, AE, AH, A (with BFE), VE, V1-V30, V (with BFE), AR, AR/A, AR/AE, AR/A1-A30, AR/AH, AR/AO. Complete Items C2.a-h below according to the building diagram specified in Item A7. In Puerto Rico only, enter meters.
 Benchmark Utilized: **NGS BM H-634 EL: 11.87'** Vertical Datum: **NGVD 1929**
 Indicate elevation datum used for the elevations in items a) through h) below. NGVD 1929 NAVD 1988 Other/Source: _____
 Datum used for building elevations must be the same as that used for the BFE.

Check the measurement used.

a) Top of bottom floor (including basement, crawlspace, or enclosure floor)	10.8	<input checked="" type="checkbox"/> feet	<input type="checkbox"/> meters
b) Top of the next higher floor	11.1	<input checked="" type="checkbox"/> feet	<input type="checkbox"/> meters
c) Bottom of the lowest horizontal structural member (V Zones only)	N/A	<input checked="" type="checkbox"/> feet	<input type="checkbox"/> meters
d) Attached garage (top of slab)	10.7	<input checked="" type="checkbox"/> feet	<input type="checkbox"/> meters
e) Lowest elevation of machinery or equipment servicing the building (Describe type of equipment and location in Comments)	10.2	<input checked="" type="checkbox"/> feet	<input type="checkbox"/> meters
f) Lowest adjacent (finished) grade next to building (LAG)	9.7	<input checked="" type="checkbox"/> feet	<input type="checkbox"/> meters
g) Highest adjacent (finished) grade next to building (HAG)	9.9	<input checked="" type="checkbox"/> feet	<input type="checkbox"/> meters
h) Lowest adjacent grade at lowest elevation of deck or stairs, including structural support	N/A	<input checked="" type="checkbox"/> feet	<input type="checkbox"/> meters

SECTION D - SURVEYOR, ENGINEER, OR ARCHITECT CERTIFICATION

This certification is to be signed and sealed by a land surveyor, engineer, or architect authorized by law to certify elevation information. I certify that the information on this Certificate represents my best efforts to interpret the data available. I understand that any false statement may be punishable by fine or imprisonment under 18 U.S. Code, Section 1001.

Check here if comments are provided on back of form. Were latitude and longitude in Section A provided by a licensed land surveyor? Yes No
 Check here if attachments.

Certifier's Name **ROBERT B. STRAYER JR** License Number **5027**
 Title **VICE PRESIDENT** Company Name **STRAYER SURVEYING & MAPPING, INC**
 Address **742 SHAMROCK BLVD** City **VENICE** State **FL** ZIP Code **34293**
 Signature *[Signature]* Date **2-12-15** Telephone **941-497-1290**


[Signature]
 PLACE
 STAMP
5027
 HERE
2/17/15

IMPORTANT: In these spaces, copy the corresponding information from Section A.	FOR INSURANCE COMPANY USE
Building Street Address (including Apt., Unit, Suite, and/or Bldg. No.) or P.O. Route and Box No. 200 ROBERTS ROAD	Policy Number:
City NOKOMIS State FL ZIP Code 34275	Company NAIC Number:

SECTION D – SURVEYOR, ENGINEER, OR ARCHITECT CERTIFICATION (CONTINUED)

Copy both sides of this Elevation Certificate for (1) community official, (2) insurance agent/company, and (3) building owner.

Comments FILE # 15-02-37. THE A/C UNIT OUTSIDE WAS USED AS THE LOWEST MACHINERY SERVICING THE BUILDING AT ELEVATION 10.2' CERTIFICATE NOT VALID WITHOUT SIGNATURE & RAISED SEAL.

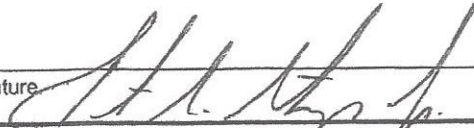Signature  Date 2-12-15

SECTION E – BUILDING ELEVATION INFORMATION (SURVEY NOT REQUIRED) FOR ZONE AO AND ZONE A (WITHOUT BFE)

For Zones AO and A (without BFE), complete Items E1–E5. If the Certificate is intended to support a LOMA or LOMR-F request, complete Sections A, B, and C. For Items E1–E4, use natural grade, if available. Check the measurement used. In Puerto Rico only, enter meters.

- E1. Provide elevation information for the following and check the appropriate boxes to show whether the elevation is above or below the highest adjacent grade (HAG) and the lowest adjacent grade (LAG).
 - a) Top of bottom floor (including basement, crawlspace, or enclosure) is _____ feet meters above or below the HAG.
 - b) Top of bottom floor (including basement, crawlspace, or enclosure) is _____ feet meters above or below the LAG.
- E2. For Building Diagrams 6–9 with permanent flood openings provided in Section A Items 8 and/or 9 (see pages 8–9 of Instructions), the next higher floor (elevation C2.b in the diagrams) of the building is _____ feet meters above or below the HAG.
- E3. Attached garage (top of slab) is _____ feet meters above or below the HAG.
- E4. Top of platform of machinery and/or equipment servicing the building is _____ feet meters above or below the HAG.
- E5. Zone AO only: If no flood depth number is available, is the top of the bottom floor elevated in accordance with the community's floodplain management ordinance? Yes No Unknown. The local official must certify this information in Section G.

SECTION F – PROPERTY OWNER (OR OWNER'S REPRESENTATIVE) CERTIFICATION

The property owner or owner's authorized representative who completes Sections A, B, and E for Zone A (without a FEMA-issued or community-issued BFE) or Zone AO must sign here. The statements in Sections A, B, and E are correct to the best of my knowledge.

Property Owner's or Owner's Authorized Representative's Name _____

Address _____ City _____ State _____ ZIP Code _____

Signature _____ Date _____ Telephone _____

Comments _____

Check here if attachments.

SECTION G – COMMUNITY INFORMATION (OPTIONAL)

The local official who is authorized by law or ordinance to administer the community's floodplain management ordinance can complete Sections A, B, C (or E), and G of this Elevation Certificate. Complete the applicable item(s) and sign below. Check the measurement used in Items G8–G10. In Puerto Rico only, enter meters.

- G1. The information in Section C was taken from other documentation that has been signed and sealed by a licensed surveyor, engineer, or architect who is authorized by law to certify elevation information. (Indicate the source and date of the elevation data in the Comments area below.)
- G2. A community official completed Section E for a building located in Zone A (without a FEMA-issued or community-issued BFE) or Zone AO.
- G3. The following information (Items G4–G10) is provided for community floodplain management purposes.

G4. Permit Number	G5. Date Permit Issued	G6. Date Certificate Of Compliance/Occupancy Issued
-------------------	------------------------	---

- G7. This permit has been issued for: New Construction Substantial Improvement
- G8. Elevation of as-built lowest floor (including basement) of the building: _____ feet meters Datum _____
- G9. BFE or (in Zone AO) depth of flooding at the building site: _____ feet meters Datum _____
- G10. Community's design flood elevation: _____ feet meters Datum _____

Local Official's Name _____ Title _____

Community Name _____ Telephone _____

Signature _____ Date _____

Comments _____

Check here if attachments.

Building Photographs

See Instructions for Item A6.

IMPORTANT: In these spaces, copy the corresponding information from Section A.

FOR INSURANCE COMPANY USE

Building Street Address (including Apt., Unit, Suite, and/or Bldg. No.) or P.O. Route and Box No.
200 ROBERTS ROAD

Policy Number:

City NOKOMIS


State FL ZIP Code 34275

Company NAIC Number:

If using the Elevation Certificate to obtain NFIP flood insurance, affix at least 2 building photographs below according to the instructions for Item A6. Identify all photographs with date taken; "Front View" and "Rear View"; and, if required, "Right Side View" and "Left Side View." When applicable, photographs must show the foundation with representative examples of the flood openings or vents, as indicated in Section A8. If submitting more photographs than will fit on this page, use the Continuation Page.



FRONT VIEW 2-12-15

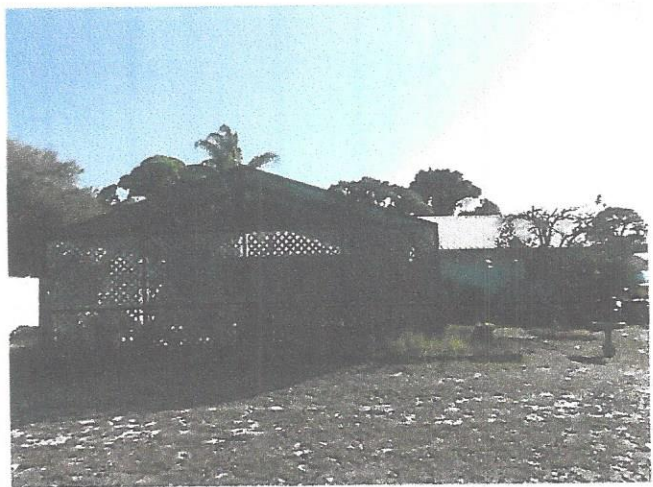

REAR VIEW 2-12-15


LEGEND

- = CONCRETE FOUNDATION (SIZE & L.A. NOTED) (C)
- = FOUNDATION (NOTED)
- = 5/8" CHASED ANCHOR BOLT (C.A. #8@36")
- = WALL & CEILING (L.A. NOTED)
- = WINDOW (L.A. NOTED)
- = DOOR (L.A. NOTED)
- = 1/2" IRON PIPE FOUND (NO T.D.)
- = SURVEY MARK
- = MEASURED DIMENSION
- = FINISHED FLOOR
- = FINISHED FLOOR FINISH
- = ELEVATION
- = ELEVATION

SECTION 25, TOWNSHIP 38S., RANGE 18E.

SCALE 1" = 20'

ASSUMED

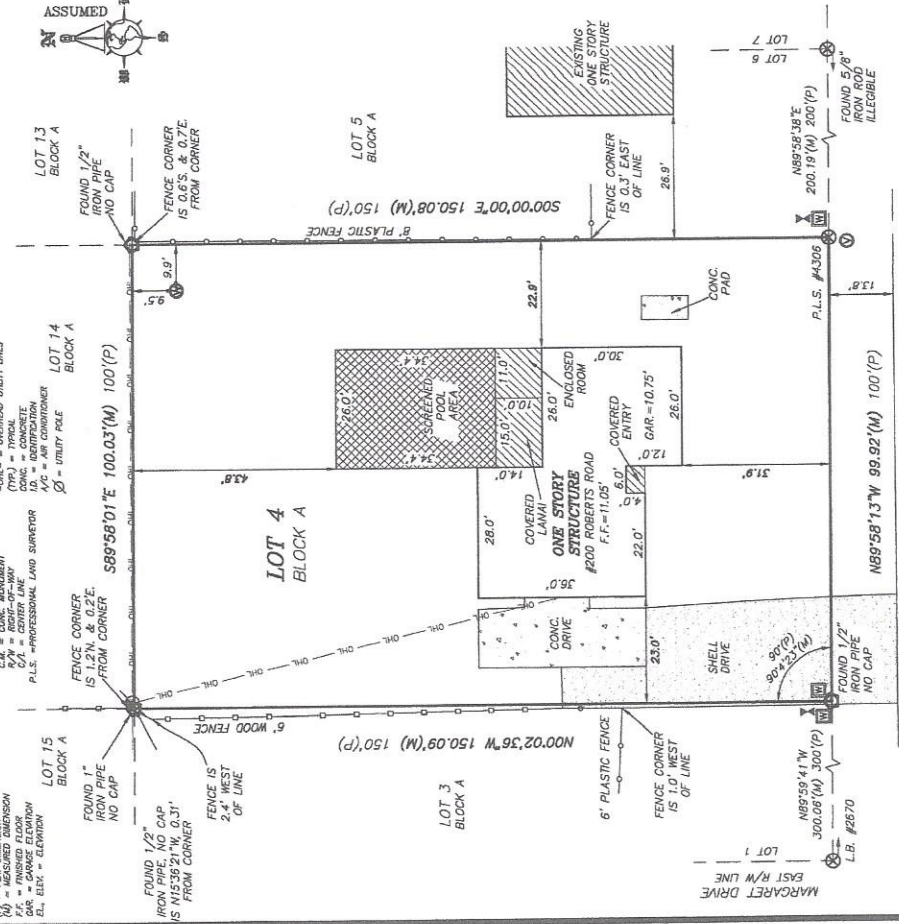

ELEVATION NOTE:

ALL ELEVATIONS SHOWN HEREON ARE BASED ON THE NATIONAL BENCH MARK #1-854 ON A N.E. BENCHMARK #1-854, ELEVATION 11.97' (N.C.G.S. 1985).

ELEVATIONS SHOWN HEREON ARE BASED ON THE NATIONAL BENCH MARK #1-854, ELEVATION 11.97' (N.C.G.S. 1985).

BOUNDARY SURVEY OF:

LOT 4, BLOCK A

LAUREL VILLA

ACCORDING TO THE PLAT THEREOF AS RECORDED IN PLAT BOOK 7, PAGES 69 & 68A, OF THE PUBLIC RECORDS OF SWASDIA COUNTY, FLORIDA

FLOOD ZONE DATA:

THIS IS NOT A CORRECTED FLOOD ZONE DETERMINATION. IT IS THE RESPONSIBILITY OF THE OWNER AND/OR ANY BUILDING RESTRICTIONS PRIOR TO CONSTRUCTION. FLOOD ZONE DETERMINATION IS FOR INFORMATIONAL PURPOSES ONLY AND IS NOT TO BE USED AS A BASIS FOR ANY OTHER PURPOSES. PROPERTY SHOWN HEREON APPEARS TO BE WITHIN FLOOD ZONE "A1B" - BASE FLOOD ELEVATION 11.1 FEET AS SHOWN ON THE LOCAL F.L.A.A. ORDINANCE TO BE APPLIED IN THE LOCAL F.L.A.A. ORDINANCE.

SURVEYORS NOTES:

DESCRIPTION FURNISHED BY CLIENT.

THE SURVEY AS SHOWN HEREON WAS PREPARED WITH THE FOLLOWING INFORMATION:

CHICAGO TITLE INSURANCE COMPANY, FILE NO. 13285, EFFECTIVE DATE 05/11/2015.

THE INFORMATION FURNISHED ON THIS SURVEY IS BASED ON THE DATA AND CAN ONLY BE CONSIDERED AS INDICATING THE GENERAL CONDITIONS AT THAT TIME.

THE SURVEYOR HAS CONDUCTED VISUAL INSPECTIONS AND CLAIMS OF ASSASSINATIONS OR OTHER INSTANCES OF WHICH HE HAS KNOWLEDGE. NO UNDERGROUND INSTALLATIONS OR IMPROVEMENTS HAVE BEEN LOCATED EXCEPT AS NOTED.

BEARINGS SHOWN HEREON ARE BASED ON THE RECORD BEARINGS SHOWN HEREON. BEARINGS SHOWN HEREON ARE NOT DEFLECTED ON PLAT.

STANDARD CHARACTERS AND OF POSITIONING MAY NOT BE DEFLECTED TO SCALE FOR CONSTRUCTION PURPOSES.

REVISIONS:

STEPHEN F. PETTIE AND MARY JANE PETTIE

QUICKEN LOANS

GIBSON MOHA. WOLFF & HRIC PL

CHICAGO TITLE INSURANCE COMPANY

DATE OF FIELD SURVEY: 05/11/2015

FIELD BOOK: 2319

CHECKED BY: B.G.A. DRAHNYI, JR., I.L.S.P.

PAGES: 15

FILE #: 15-08-37

S.T. STRAYER

1987

742 Sherman Boulevard

Weston, Florida 33433

(941) 854-4950

For (941) 497-0186

www.ststrayerurveying.com

SURVEYING & MAPPING, INC.